

**SCDHEC OFFICE OF OCEAN AND COASTAL RESOURCE MANAGEMENT
PERMIT APPLICATION PUBLIC NOTICE**

March 13, 2009

Permit Number: OCRM-09-831-G
Permit ID: 66284

The SCDHEC Office of Ocean and Coastal Resource Management has received an application for a permit for the alteration of a critical area. This application was submitted pursuant to the Coastal Zone Management Act (Act 123) of the 1977 South Carolina General Assembly. The application, in brief, is described as follows:

APPLICANT: Stephen W Durham
130 Meridian Road
Lady's Island, SC 29907

LOCATION: On and adjacent to Beaufort River at 130 Meridian Road, Lady's Island, Beaufort County, South Carolina.
TMS#: R200-017-000-0006-0000.

WORK: The work, as proposed and shown on the attached plans, consists of making additions to an existing private dock. Specifically, the applicant proposes to add an 11'x18' boat-float on the shoreward side of an existing 10'x41' floating dock. The purpose of the boat-float is for the applicant's private, recreational use.

This public notice is being distributed to all known interested persons and agencies to assist in developing facts on which a decision by OCRM can be based. Comments concerning the proposed work should be submitted in writing, setting forth sufficient detail to furnish a clear understanding of the reasons for support or opposition.

The decision to issue or deny a permit will be based on the individual merits of the application, the policies specified in the South Carolina Coastal Zone Management Act, and the considerations outlined in the State of South Carolina Coastal Zone Management Program. Interested parties who wish to be notified of final permit action must notify OCRM in writing of this request.


To assure review by OCRM, comments regarding this application must be received by OCRM on or before March 28, 2009. For further information please contact the project manager for this activity, Geordie Madlinger at 843-846-9400.

PLEASE REPLY TO:

SCDHEC OFFICE OF OCEAN AND COASTAL RESOURCE MANAGEMENT
104 Parker Drive
Beaufort, South Carolina 29906

Please refer to P/N# OCRM-09-831-G


George J Madlinger, Wetland Section Project Manager

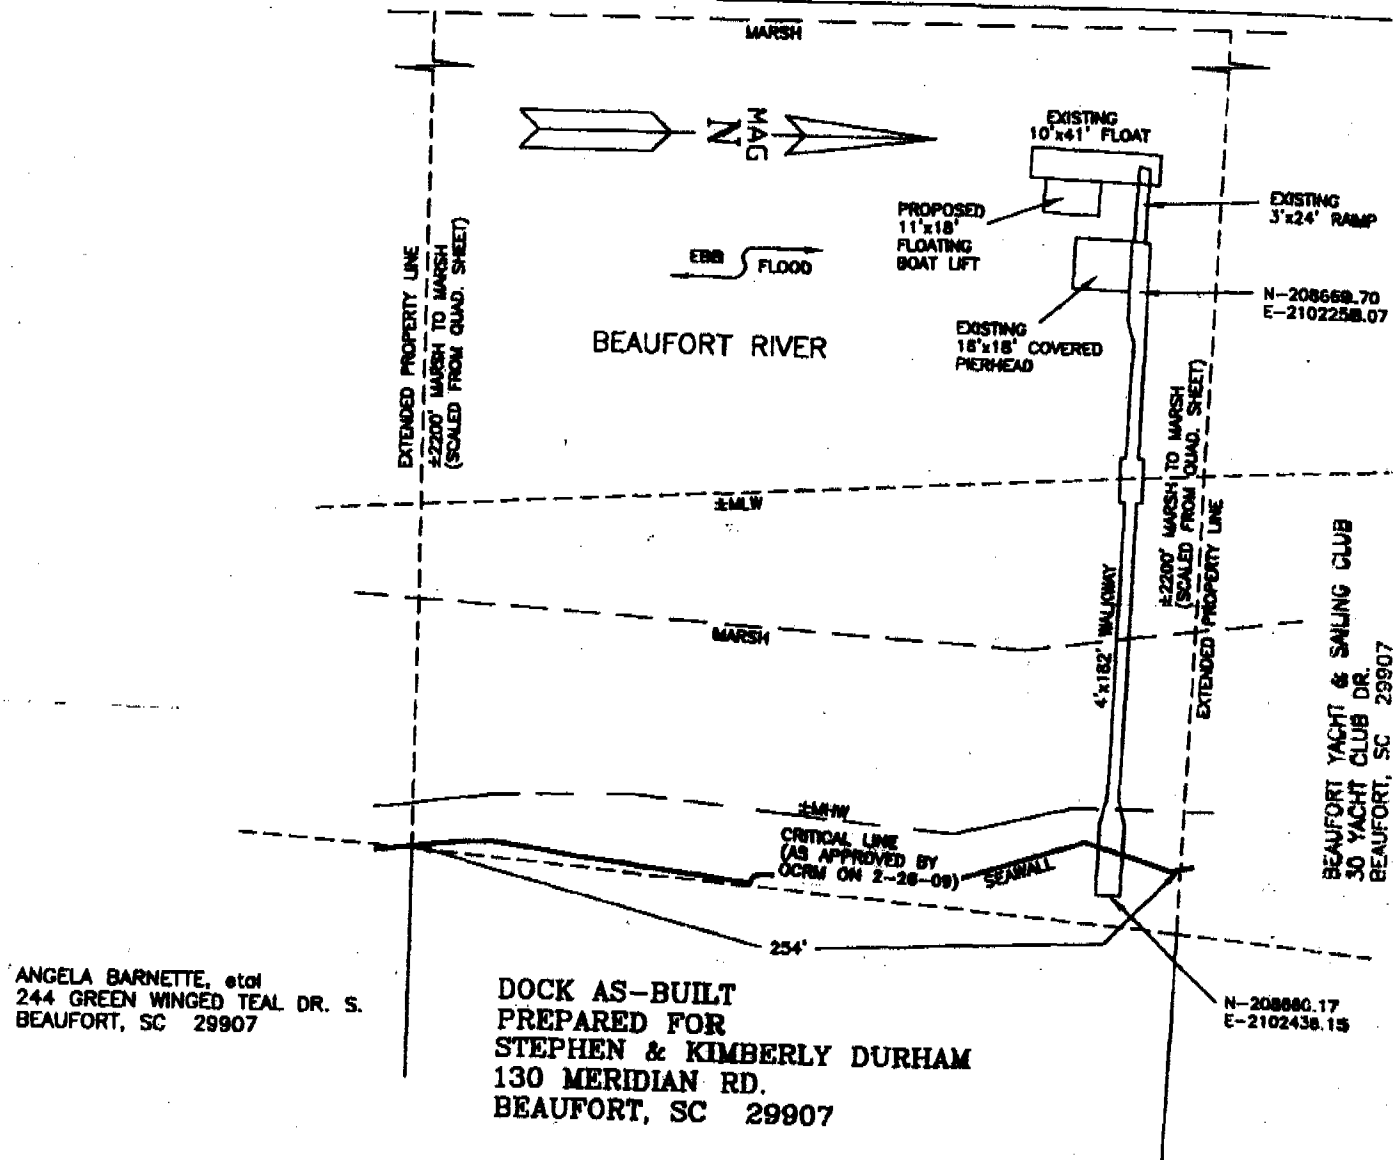

I HEREBY CERTIFY TO THE DIMENSIONS SHOWN ON THIS SKETCH THAT PERTAIN TO CRITICAL LINE AND MARSH LINE.

R200-017-000-0006-0000

0 30' 60' 120' 180'

SCALE 1" = 60'

FEBRUARY 19, 2009
P14007/MMA

David S. Youmans
DAVID S. YOUNMANS RLS 9765
BEAUFORT SURVEYING, INC.
1613 PARIS AVENUE
PORT ROYAL, S.C. 29935
PHONE (843) 524-3261

APPLICANT:
STEPHEN & KIMBERLY DURHAM
130 MERIDIAN RD., BEAUFORT

ACTIVITY: DOCK AS-BUILT

052000-09-851-G

LOCATION: LADIES ISLAND



COUNTY: BEAUFORT

DATE: 02/19/09

ADJACENT PROPERTY OWNERS

ANGELA BARNETTE, et al
244 GREEN WINGED TEAL DR. S.
BEAUFORT, SC 29907
BEAUFORT YACHT & SAILING CLUB
30 YACHT CLUB DR.
BEAUFORT, SC 29907

DOCK AS-BUILT
PREPARED FOR
STEPHEN & KIMBERLY DURHAM
130 MERIDIAN RD.
BEAUFORT, SC 29907

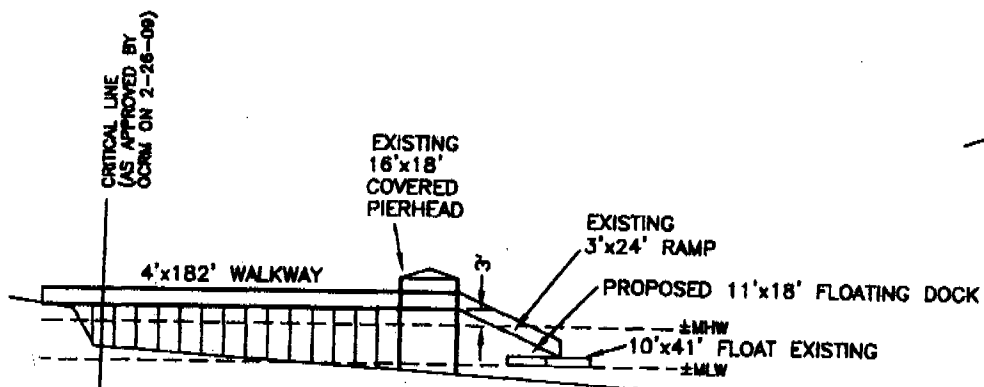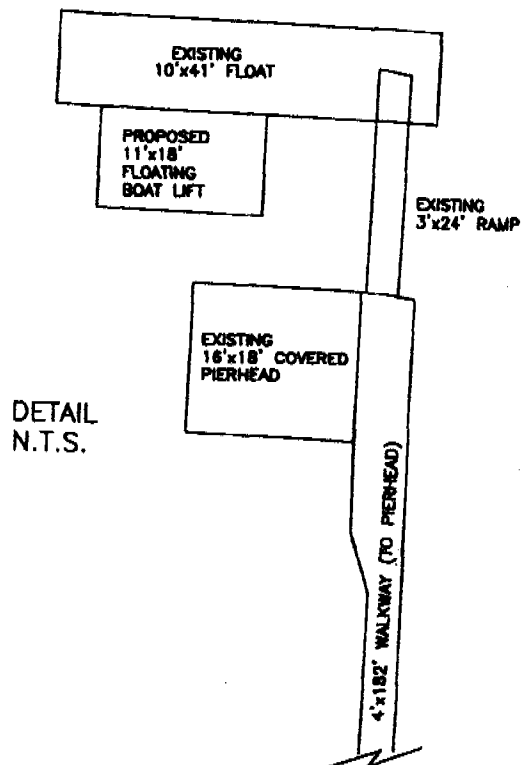

SIDE VIEW
NOT TO SCALE

R200-017-000-0006-0000

P14007/MMA


David S. Youmans
DAVID S. YOUMANS RLS 9765
BEAUFORT SURVEYING, INC.
1613 PARIS AVENUE
PORT ROYAL, S.C. 29935
PHONE (843) 524-3261

APPLICANT:
STEPHEN & KIMBERLY DURHAM
130 MERIDIAN RD., BEAUFORT
ACTMITY: DOCK AS-BUILT

LOCATION: LADIES ISLAND
COUNTY: BEAUFORT
DATE: 02/19/09

ADJACENT PROPERTY OWNERS
ANGELA BARNETTE, et al
244 GREEN WINGED TEAL DR. S.
BEAUFORT, SC 29907
BEAUFORT YACHT & SAILING CLUB
30 YACHT CLUB DR.
BEAUFORT, SC 29907

OCRM-09-831-G

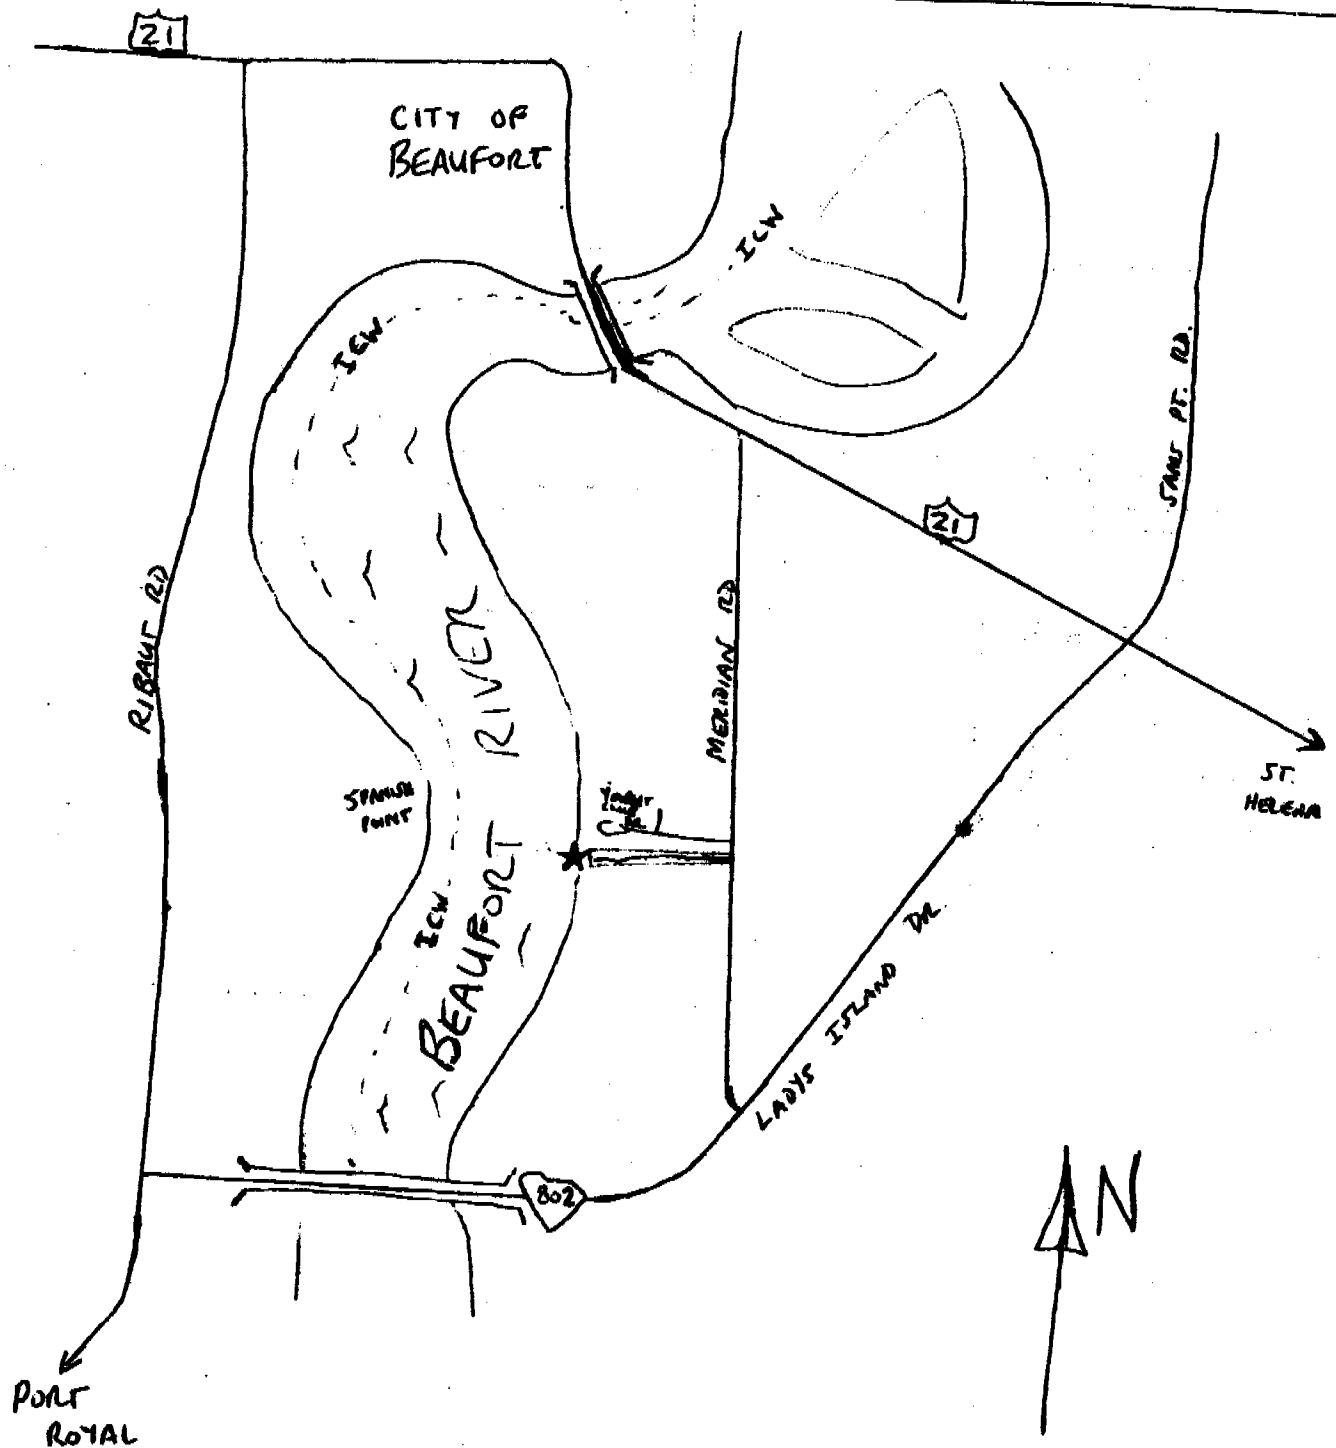

130 MERIDIAN RD
BEAUFORT, SC 29907

LOCATION MAP

APPLICANT:

STEPHEN & KIMBERLY DURHAM
130 MERIDIAN RD., BEAUFORT

ACTMITY: DOCK AS-BUILT

CCM-09-851-G

LOCATION: LADIES ISLAND

COUNTY: BEAUFORT

DATE: 02/19/09

ADJACENT PROPERTY OWNERS

ANGELA BARNETTE, et al
244 GREEN WINGED TEAL DR. S.
BEAUFORT, SC 29907

BEAUFORT YACHT & SAILING CLUB
30 YACHT CLUB DR.
BEAUFORT, SC 29907